

- ☒ NO EXCEPTIONS TAKEN
- ☐ REJECTED
- ☐ SUBMIT SPECIFIED ITEM
- ☐ REVISE AND RESUBMIT
- ☐ MAKE CORRECTIONS AS NOTED

RECEIVED  
JUN - 2 2004

Checking is only for general conformance with the design concept of the project and general compliance with the information given in the contract documents. Any change shown is subject to the requirements of the plans and specifications. Contractor is responsible for the design which shall be confirmed with the project engineer, the fabrication processes and techniques of construction, coordination of his work with that of all other trades, and the satisfactory performance of his work.

(6) 3/4" DIA. PERFORATIONS

03411


CAMBRIDGE DEPT. OF PUBLIC WORKS

DATE 6-8-04

R 3/4"

VORTECHS®  
STORMWATER  
TREATMENT  
SYSTEM

MATERIAL: Gray iron conforming to ASTM A48, CL.30B and AASHTO M105

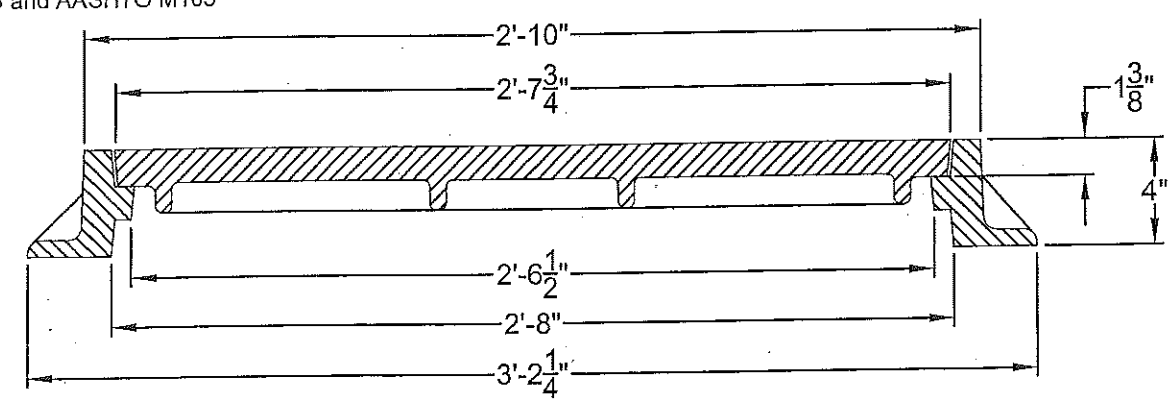

This drawing shows the general configuration of the casting or castings to be supplied. Dimensions are approximate and may vary. Drawings should not be scaled where there are no dimensions shown.

Weight of casting(s), when shown, is based on final dimensions and is estimated only.


There are no representations made concerning the suitability of the design of the materials specified since the manufacturer has no control over upon final construction or installation of the product herein set forth.

1012D


**Vortechs®**  
200 Enterprise Drive  
Scarborough, ME 04074  
Tel.: 207-885-9830  
Fax: 207-885-9825

VORTECHS SYSTEM - 30" DIA. x 4" H MH FRAME AND COVER  
AASHTO HS20-44 HIGHWAY LOADING

DATE: 01/23/02	SCALE: NONE	FILE NAME: 30CMPBL4D	DRAWN BY: DMF	CHECKED BY: NDG
----------------	-------------	----------------------	---------------	-----------------

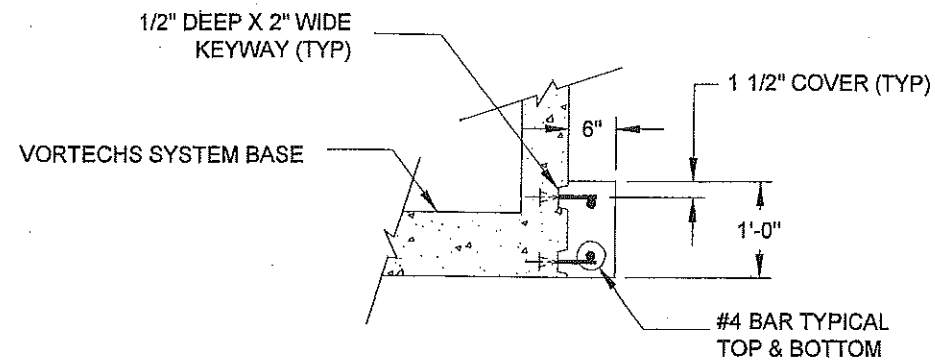

**TYPICAL ANTI-FLOATATION COLLAR**  
(CAST-IN-PLACE COLLAR BY OTHERS)

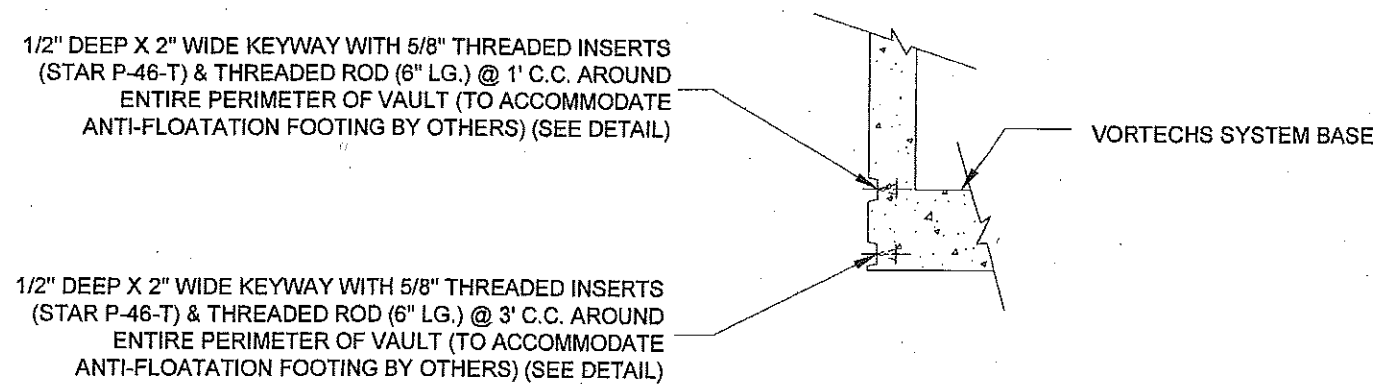

**TYPICAL COLLAR ATTACHMENT INSERTS**

NOTE: VORTECHNICS SHALL PROVIDE THREADED INSERTS AND REINFORCING STEEL.  
PURCHASER OF VORTECHS SYSTEM SHALL PROVIDE CAST-IN-PLACE COLLAR INCORPORATING REINFORCING STEEL.

RTND



**PROPOSED ANTI-FLOATATION COLLAR DETAILS**  
**6" WIDE X 1'-0" DEEP CAST-IN-PLACE**  
**VORTECHS® STORMWATER TREATMENT SYSTEM**

DATE: 5/07/03 SCALE: None FILE NAME: FLTCLR6 DRAWN BY: DMF CHECKED BY: NDG

INLET PIPE MUST BE SET AT  
90° TO SYSTEM WALL

GAP TO BE  
FILLED WITH  
SIKAFLEX-1A TYP.

5'-8 1/2"

 $1'-3''$ 

## BAFFLE A

(VIEWED FROM DOWNSTREAM)

SEALED WITH 1/4" THICK x 4" WIDE BUTYL  
MASTIC SEALANT CONFORMING TO ASTM C990  
BETWEEN BASE SECTION AND ALUMINUM CHAMBER  
TYPICAL OF ALL LONG WALL TANGENT POINTS

BUNA N EXTRUDED SEAL WITH  
SIKAFLEX-1A INSTALLED AT BASE  
AND CONCRETE FLOOR

### PLAN VIEW

2 1/2" DEEP x 5 1/2" WIDE KEYWAY  
— IN SIDE WALLS FOR BAFFLES A & B  
JOINTS TO BE CAULKED WITH  
POLYURETHANE ELASTOMERIC  
SEALANT

GAP TO BE  
FILLED WITH  
SIKAFLEX-1A TYP

 $g^n$ 

BAFFLE B

(FLOW CONTROL PLATES NOT SHOWN FOR CLARITY)  
(VIEWED FROM DOWNSTREAM)

DESIGN NOTES:

1. CONCRETE MINIMUM STRENGTH - 5,000 PSI AT 28 DAYS
  2. STEEL REINFORCEMENT - ASTM A-615, GRADE 60 - 1" MIN. COVER REFER TO ROTONDO PRECAST DRAWING 7 K-0-5
  3. DESIGN LOADING - AASHTO HS20-44
  4. CONSTRUCTION JOINTS - SEALED WITH 1" DIA. BUTYL RUBBER
  5. DESIGN SPECIFICATION - ACI 318
- AASHTO LOAD FACTOR DESIGN METHOD

ASSUMPTIONS:

1. GROUND WATER ELEVATION AT TOP OF TANK
2. EARTH COVER VARIES FROM 0'-0" MIN. TO 5'-0" MAX
3. 2'-0" LIVE LOAD SURCHARGE APPLIED TO 8'-0" DEPTH
4. LIVE LOAD IMPACT 0" TO 1'-0" COVER I = 30%
5. COEFFICIENT OF ACTIVE EARTH PRESSURE  $K_a = 0.33$
6. DRY EARTH DENSITY 120 PCF
7. SATURATED EARTH DENSITY 120 PCF
8. DRY EARTH LATERAL PRESSURE = 120 PCF (0.33) = 39.6 PSF
9. SATURATED EARTH DENSITY 120 PCF
10. 120 PCF - 62.4 = 57.6 PCF; 57.6 PCF (0.33) = 19.0 PSF

GENERAL NOTES:

1. INTERNAL COMPONENTS SHALL BE FABRICATED OF ALUMINUM ALLOY 5052-H32 IN ACCORDANCE WITH ASTM B209
2. MANHOLE RISERS, GRADE RINGS OR BLOCK REQUIRED BETWEEN TOP OF THE VORTECHS SYSTEM AND THE BASE OF THE MANHOLE FRAMES SHALL BE THE RESPONSIBILITY OF OTHERS AND SHALL BE IN ACCORDANCE WITH ALL APPLICABLE STANDARDS
3. FLOW CONTROL PLATE(S) TO BE SUPPLIED BY VORTECHNICS AND INSTALLED ON THE INLET FACE OF BAFFLE B. ORIFICE PLATE OPENING IS TO BE CENTERED HORIZ. & VERT. OVER LOWER CONCRETE OPENING. WEIR PLATE OPENING IS TO BE CENTERED HORIZ. & VERT. OVER UPPER CONCRETE OPENING.
4. THE WATER SURFACE ELEVATION IN THE VORTECHS SYSTEM IS EXPECTED TO BE AT OR BELOW INSIDE TOP OF VAULT DURING THE DESIGN STORM

### WEIGHT AND DELIVERY INFORMATION

VORTECHS SYSTEM IS DELIVERED  
IN TWO (2) PIECES

HEAVIEST PICK IS 19 TONS  
(APPROXIMATE)

-COMPONENTS-

TOP SECTION = 14 TONS  
BASE SECTION = 14 TONS  
(2) BAFFLES = 2 TONS EACH  
ALUMINUM CHAMBER = 1 TON

BASE SECTION IS DELIVERED WITH BAFFLES AND ALUMINUM CHAMBER INSTALLED

RTND-A

**ASSEMBLY**  
NOT INTENDED TO DEPICT  
DELIVERY CONFIGURATION

LEFT SIDE VIEW

1' HIGH X 6" WIDE CAST-IN-PLACE  
ANIT-FLOTATION COLLAR REQUIRED.  
SEE DRAWING FLTCLR6 FOR DETAILS. INSERTS  
AND REINFORCING PROVIDED BY VORTECHNICS.  
CONCRETE AND LABOR FOR CASTING TO BE  
PROVIDED BY OTHERS.

**ELEVATION VIEW**  
(SWIRL CHAMBER NOT SHOWN FOR CLARITY)

PROJECT #2055 SYSTEM INFORMATION

RIM ELEVATION = +/-  
TOP OF TANK ELEVATION = 8.22'  
INLET PIPE INVERT = 3.80'  
INLET PIPE = 18" RCP  
OUTLET PIPE INVERT = 3.80'  
OUTLET PIPE = 18" RCP  
OUTSIDE BOTTOM OF TANK ELEVATION = -0.12'

This CADD file is for the purpose of specifying stormwater treatment equipment to be furnished by Vortech, Inc. and may only be transferred to other documents exactly as provided by Vortech, Inc. Title block information, excluding the Vortech Stormwater Treatment System designation and patent number, may be deleted if necessary. Revisions to any part of this CADD file without prior coordination with Vortech, Inc. shall be considered unauthorized use of proprietary information.

## REVISION

<b>REVISION</b>	
<b>REV</b>	<b>DESCRIPTION</b>



Vortech

200 Enterprise Drive  
Scarborough, ME 04074  
Tel.: 207-885-9830  
Fax: 207-885-9825

SCALE: 1/4" = 1'-0"

DRAWN BY: SEP

CHECKED BY: WSG

FILE NAME: 2055S

DATE: 05/20/04